


MAYFLOWER PLATINUM

Survey no. 82/1, Mallapur, Hyderabad – 500 076.
Owned & Developed by: M/s. Modi Properties Pvt. Ltd.
Head office; 5-4-187/3&4 M G Road Secunderabad.

Details of Additions & Alterations

Flat No	602	Block no.	'B'
Flat Area	2140 sft	Type	Deluxe / Luxury
Buyer Name	Mrs. Vanita Agarwal		
Phone No.	9246583781/9248148152	Email	vatnagaarwal103@gmail.com

I hereby confirm that I have given the details of the minor additions and alterations that are required in the above referred flat in the pages attached herein. Please complete the changes suggested by me. I agree to pay the charges, if any, for the additions and alterations that I have asked you to make, as per the rates suggested by you. I shall deliver all the materials that are required to be provided by me at the site on or before _____. In case I fail to deliver these items to the site by the specified date, you may complete the works in the flat as per the standard items provided by you.

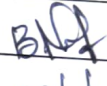Buyers sign		Engg. Sign	
Date:	29/06/2021	Date	29/6/21

Note:

1. Colour shades of paints may vary from batch to batch & company to company. The Builder will not take responsibility of quality of work for dark shades especially green & blue.
2. Shade / colour of natural material like marble and granite can't be guaranteed and may vary from lot to lot. Cracks like appearance in marble is a natural feature and Builder shall not be responsible for repairs or replacement.
3. Availability of bathroom or flooring tiles of the same type /colour/make can not be guaranteed and closest possible type/colour/make may be used in its place.
4. No further change shall be permitted from this day.
5. Please sign on all pages.

Buyers sign:



Engg. Sign:



Date: 29/06/21

Choice of colours:

Yet to be discussed.

Changes in flooring:


1) All tiles to be brought by customer.

* Flooring to be default as per ~~per~~ ~~on~~ 2x2 Vertiefed tiles

* Kitchen to be 2x2 V. Tiles

BKOP
28/7

Buyers sign:

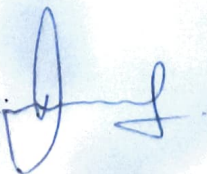


Engg. Sign:



Date: 29/6/24

Changes in electrical points: (mark on plan)

1) All Switches to be default.

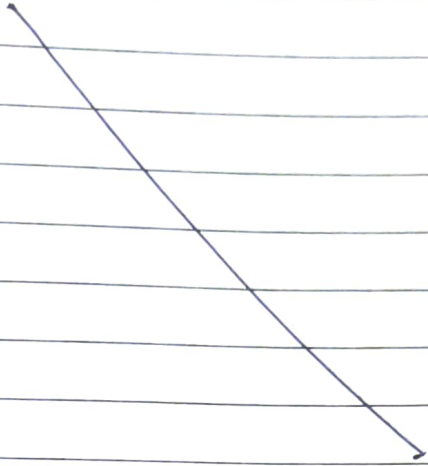


Choice of Bathroom tiles, CP fittings & Sanitary ware:

- 1) Bathroom tiles to be brought by customer. All default
- 2) All Sanitary to be brought by customer.
- 3) Commode & Shower to be interchanged in CBR toilet.
- * Bathrooms, Utility & Sitout to be default

10/11/2022

BAH
28

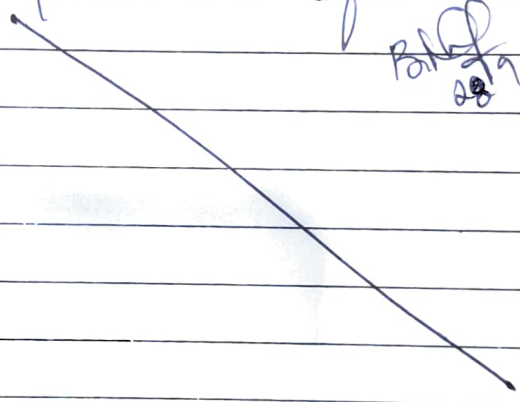


Buyers sign:

Engg. Sign:

Date: 29/6/21


Changes in kitchen platform: (mark on plan)

Yet to be discussed.

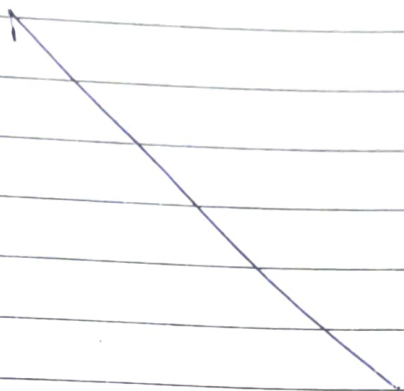

Other Changes:

No changes.

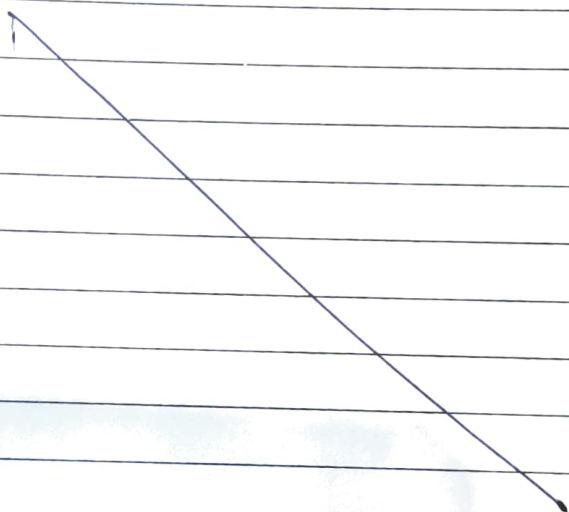


Buyers sign:

Handwritten signature of the buyer.

Engg. Sign:


Handwritten signature of the engineer.

Date: 29/6/21

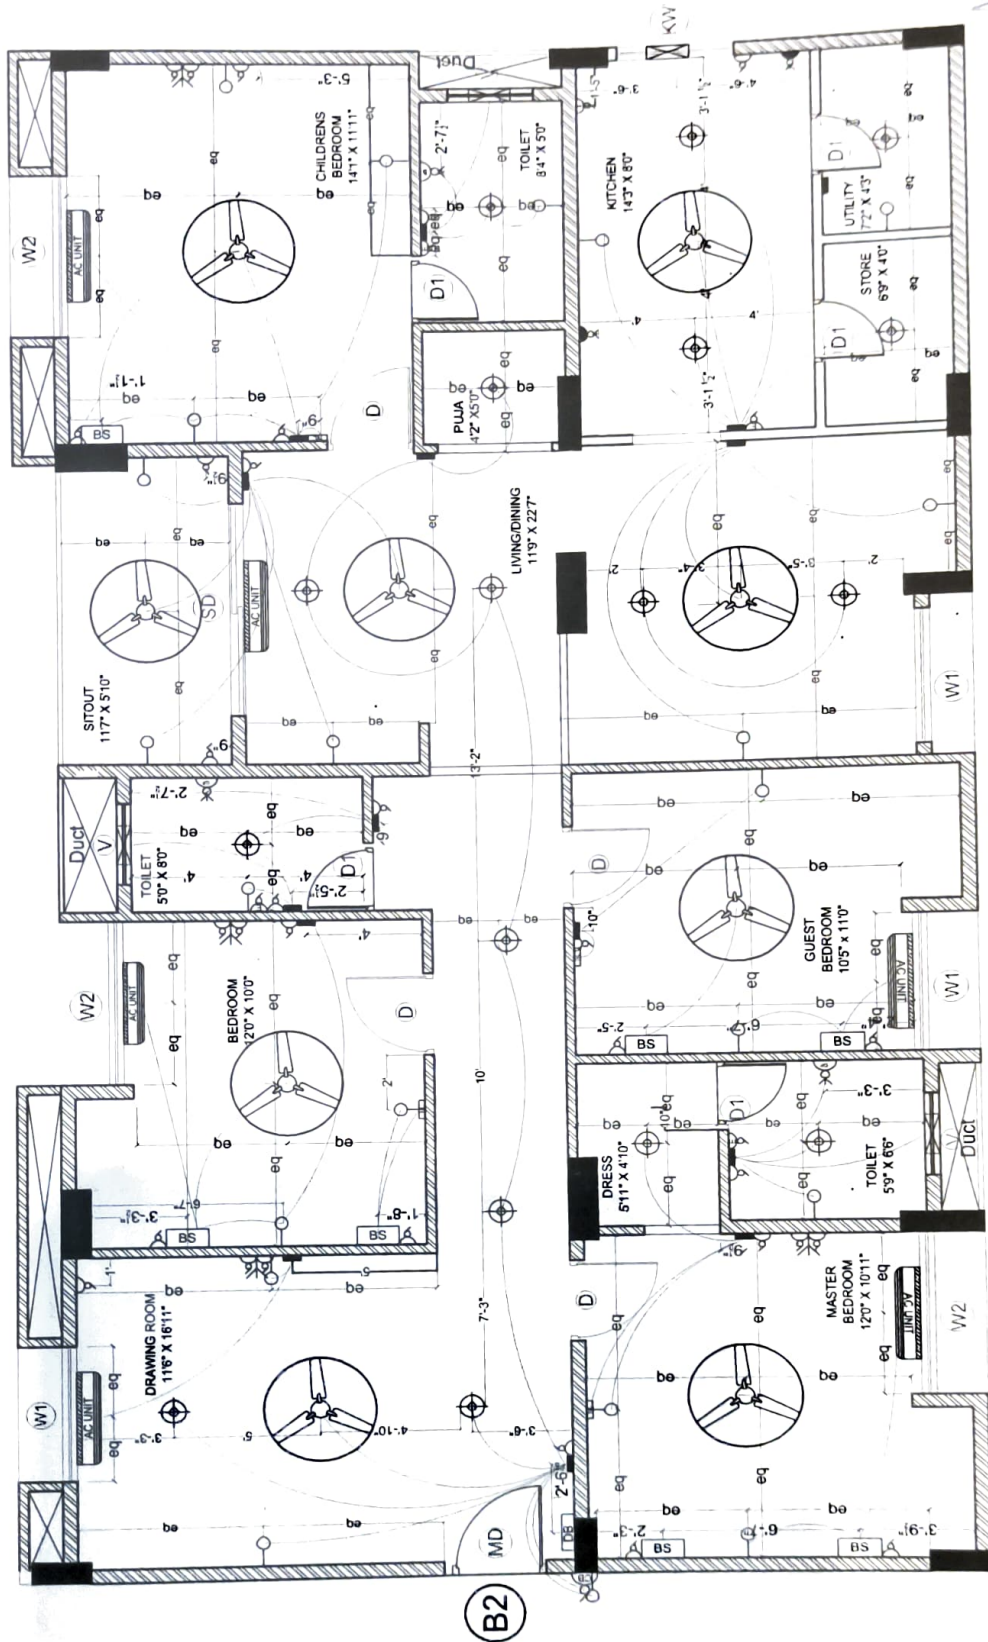

Handwritten signature/initials

Description	Direction	Owners & Developers :	Date :	Promoted by	
ELECTRICAL PLAN OF FLAT-B2		Modi Properties Pvt Ltd. Project Name & Phase : MAYFLOWR PLATINUM	18.08.2020	Prepared By :	Modi Properties Pvt. Ltd Phone: +91-40-66335551
				Approved By : Soham Modi	
				Scale : N.T.S	

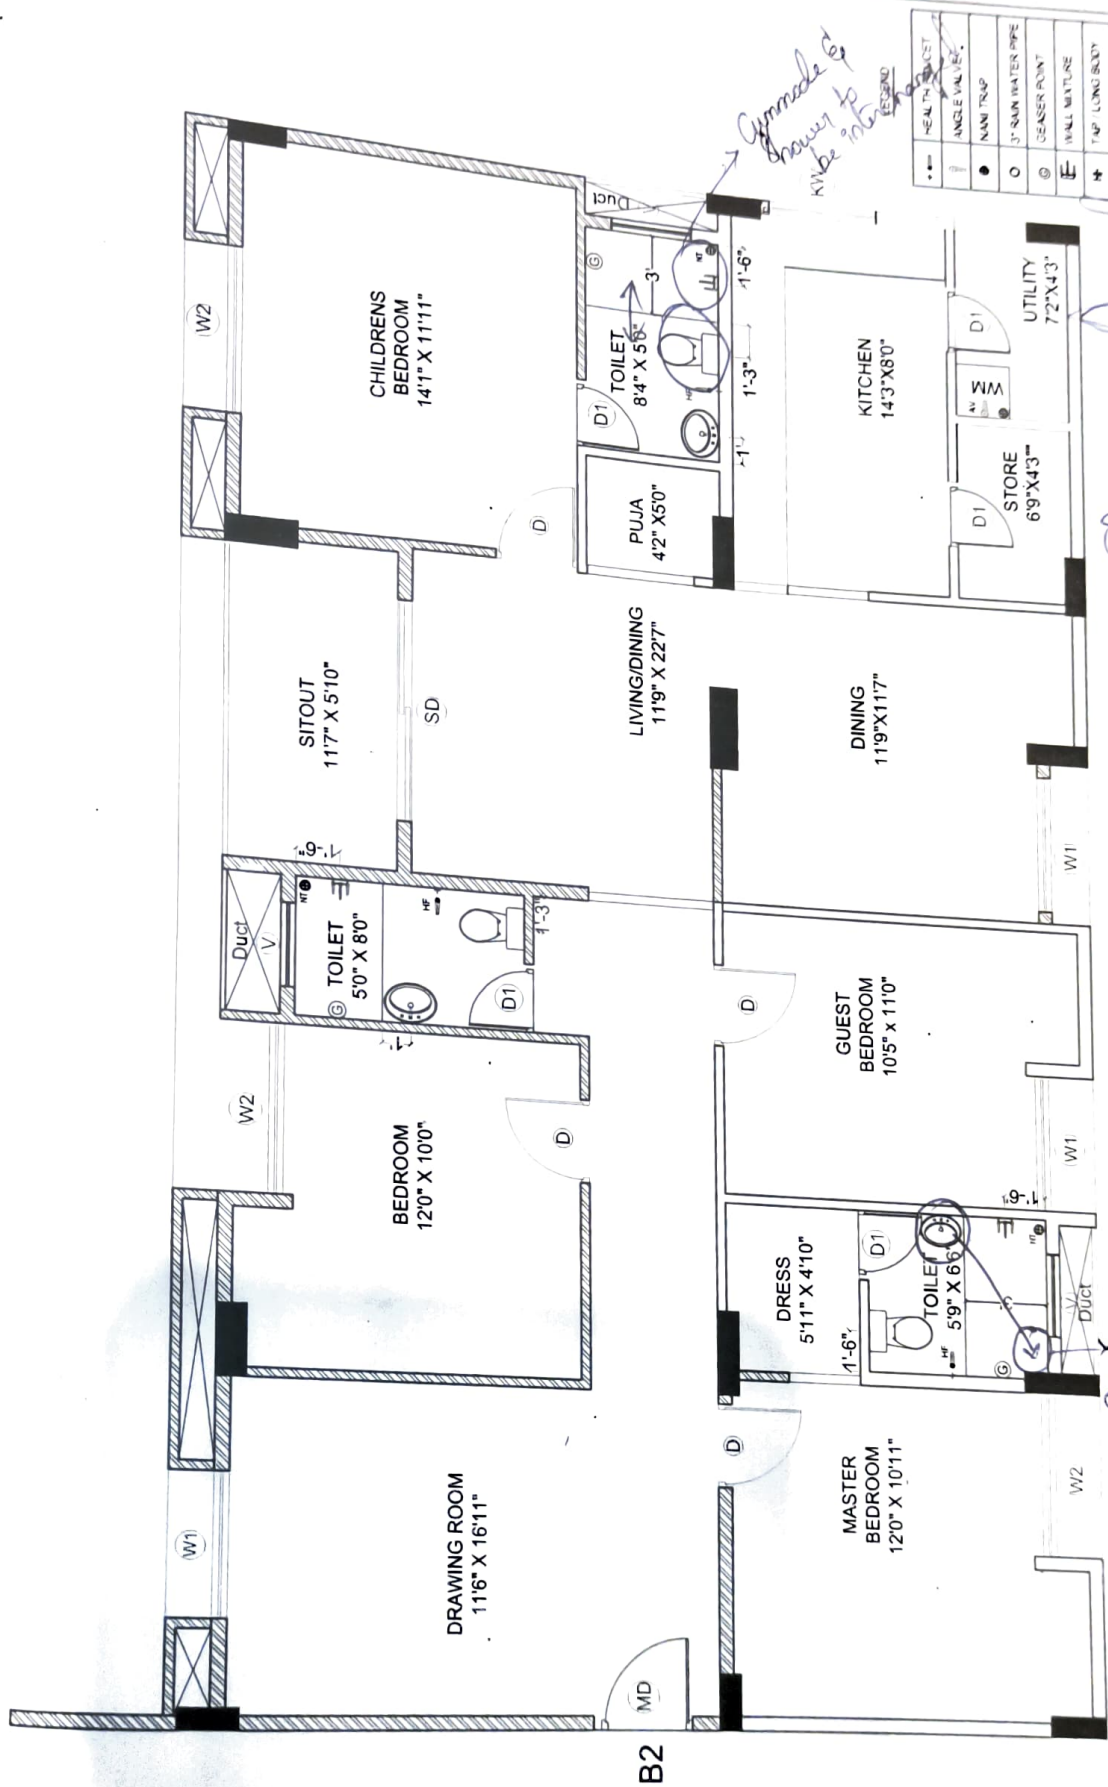

Description

Direction



Owners & Developers :

Modi Properties Pvt Ltd.

Project Name & Phase :

MAYFLOWER PLATINUM

Date :

18.08.2020

Prepared By :

Approved By :


Scale :

Promoted by

Modi Properties Pvt. Ltd

Phone: +91 40-60335551

PLUMBING PLAN OF FLAT.NO.B-2

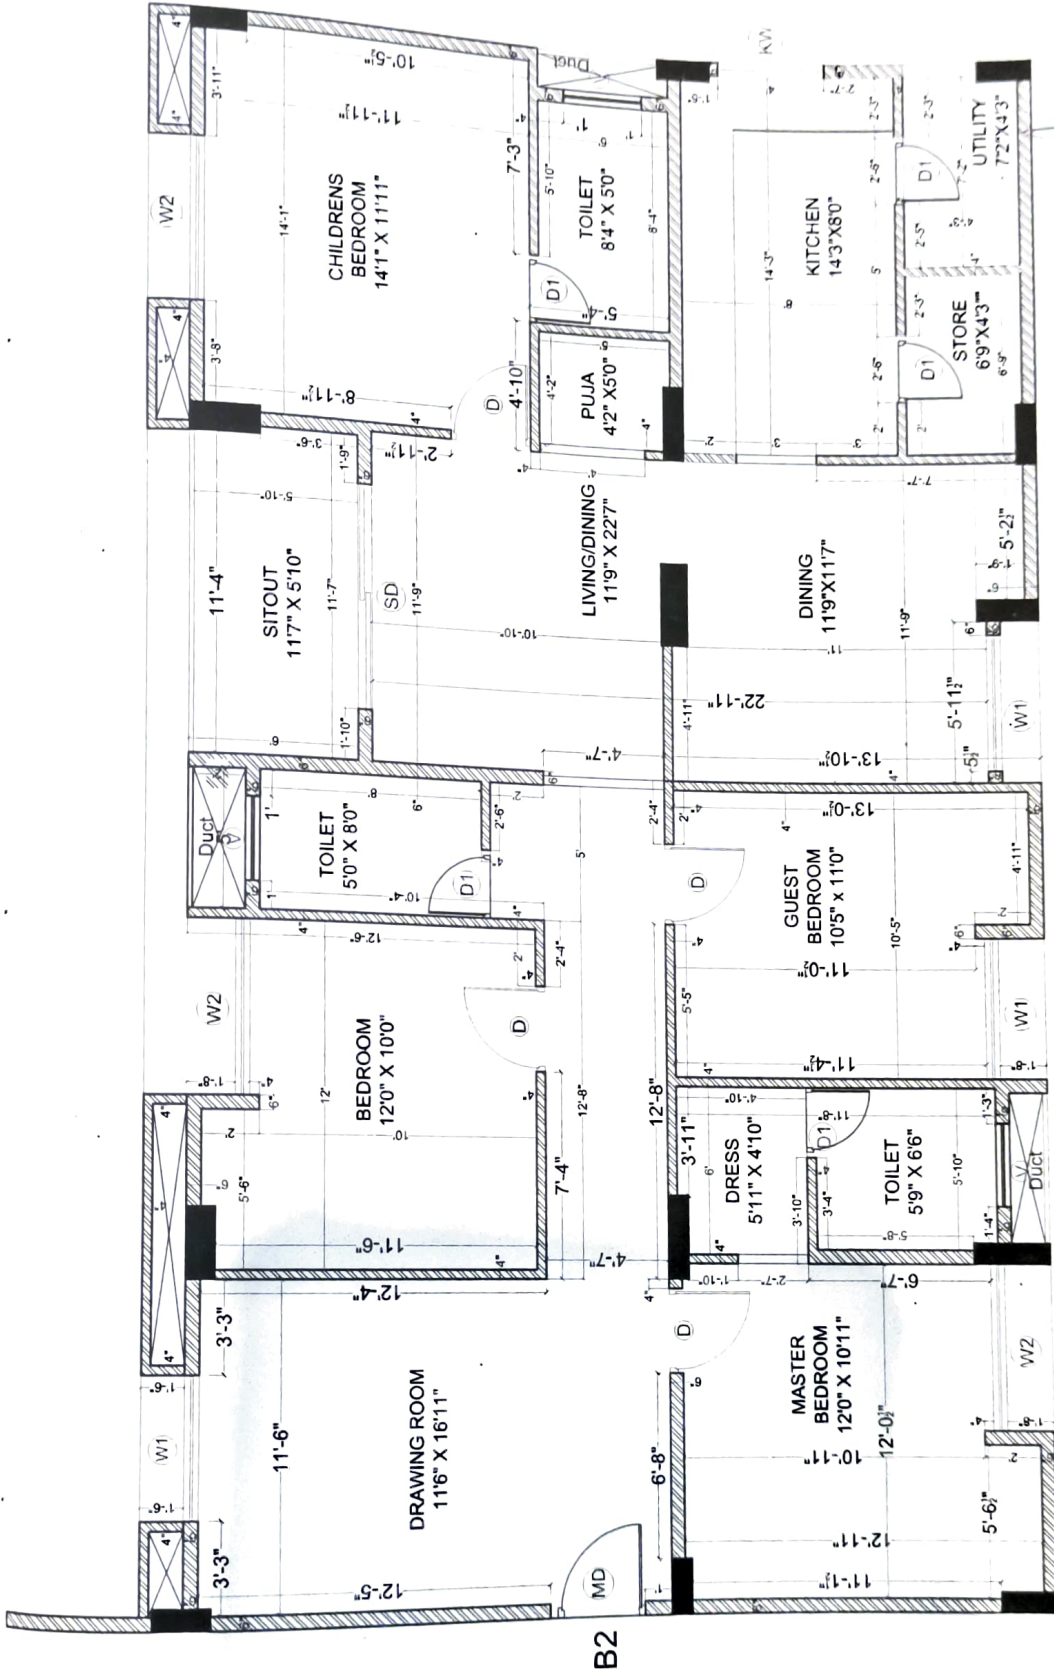

Handwritten signature

Description	Owners & Developers :	Date :	Promoted by
WORKING DRAWING OF FLAT.NO.B-2	Direction	Prepared By :	Modi Properties Pvt. Ltd Phone: +91-40-60335551
	N	Approved By :	
		Scale :	
	Project Name & Phase :		
	MAYFLOWR PLATINUM		